

INTERIOR COLORS			
Location	Material	Manufacturer	Pattern - Color
Walls & Ceiling (except Lavatory)	Acoustical fabric	MDC	1701 DESERT
Accent walls (2 locations) Foyer streetside wall & CSA rear wall	Acoustical fabric	MDC	1763 SESAME
Lavatory Walls	Laminate	Formica	899-58 Desert Beige
Floor Teller/ATM Operations area Lobby Lavatory	Vinyl Tile	FLEXCO	CE=119 WHITE W/BEIGE
Floor Customer service area	Carpet		CUSTOM REFUGE
Cabinet body, Cabinet doors, Doors, Desk legs	Laminate	Formica	Vosges Pear 1150-43
Horizontal surfaces (desk, counters, Etc.)	Laminate	Wilsonart	Graphite Nebula A4623-60
Pocket & swing doors	Laminate	Formica	Vosges Pear 1150-43
Door frames/trim	Paint	Benjamin Moore	White Vanilla 2017-70
Seat cushions and seat backs	Fabric	Momentum	Intermix - Midnight
Exterior awning fabric color	Fabric	Open	Open


SECTION VIEWS SHOWN PAGE 4 of 8

PEDESTAL DIMENSIONS  
18 11/16" SQUARE  
X 28 1/2" HIGH

CUSTOMER APPROVAL		STATUS		DRAWING NUMBER		CHASSIS/BODY		TITLE	
NAME: (print) _____		PRELIMINARY SALES DRAWING		SUNTRUST_ELEVATIONS_6-6-12		M2-106/MODULAR		SUNTRUST BANKS	
SIGNATURE: _____		ALL DIMENSIONS		TYPE		DATE		VIEW	
TITLE: _____		ARE APPROXIMATIONS		AS-BUILT		6/6/12		INTERIOR PLAN VIEW	
DATE: _____				PHONE: 407-323-9414		FAX: 407-330-2068		DRAWN BY GAJ	
				210 TECH DRIVE		32771		SCALE	
				SANFORD, FLORIDA				N/A	
								SHEET	
								1 of 8	
								SIZE	
								B	

# MBF Industries

These drawings and/or specifications are the proprietary property and trade secrets of MBF Ind. and are issued in strict confidence. No reproduction or use shall be made without prior written consent of MBF Ind.

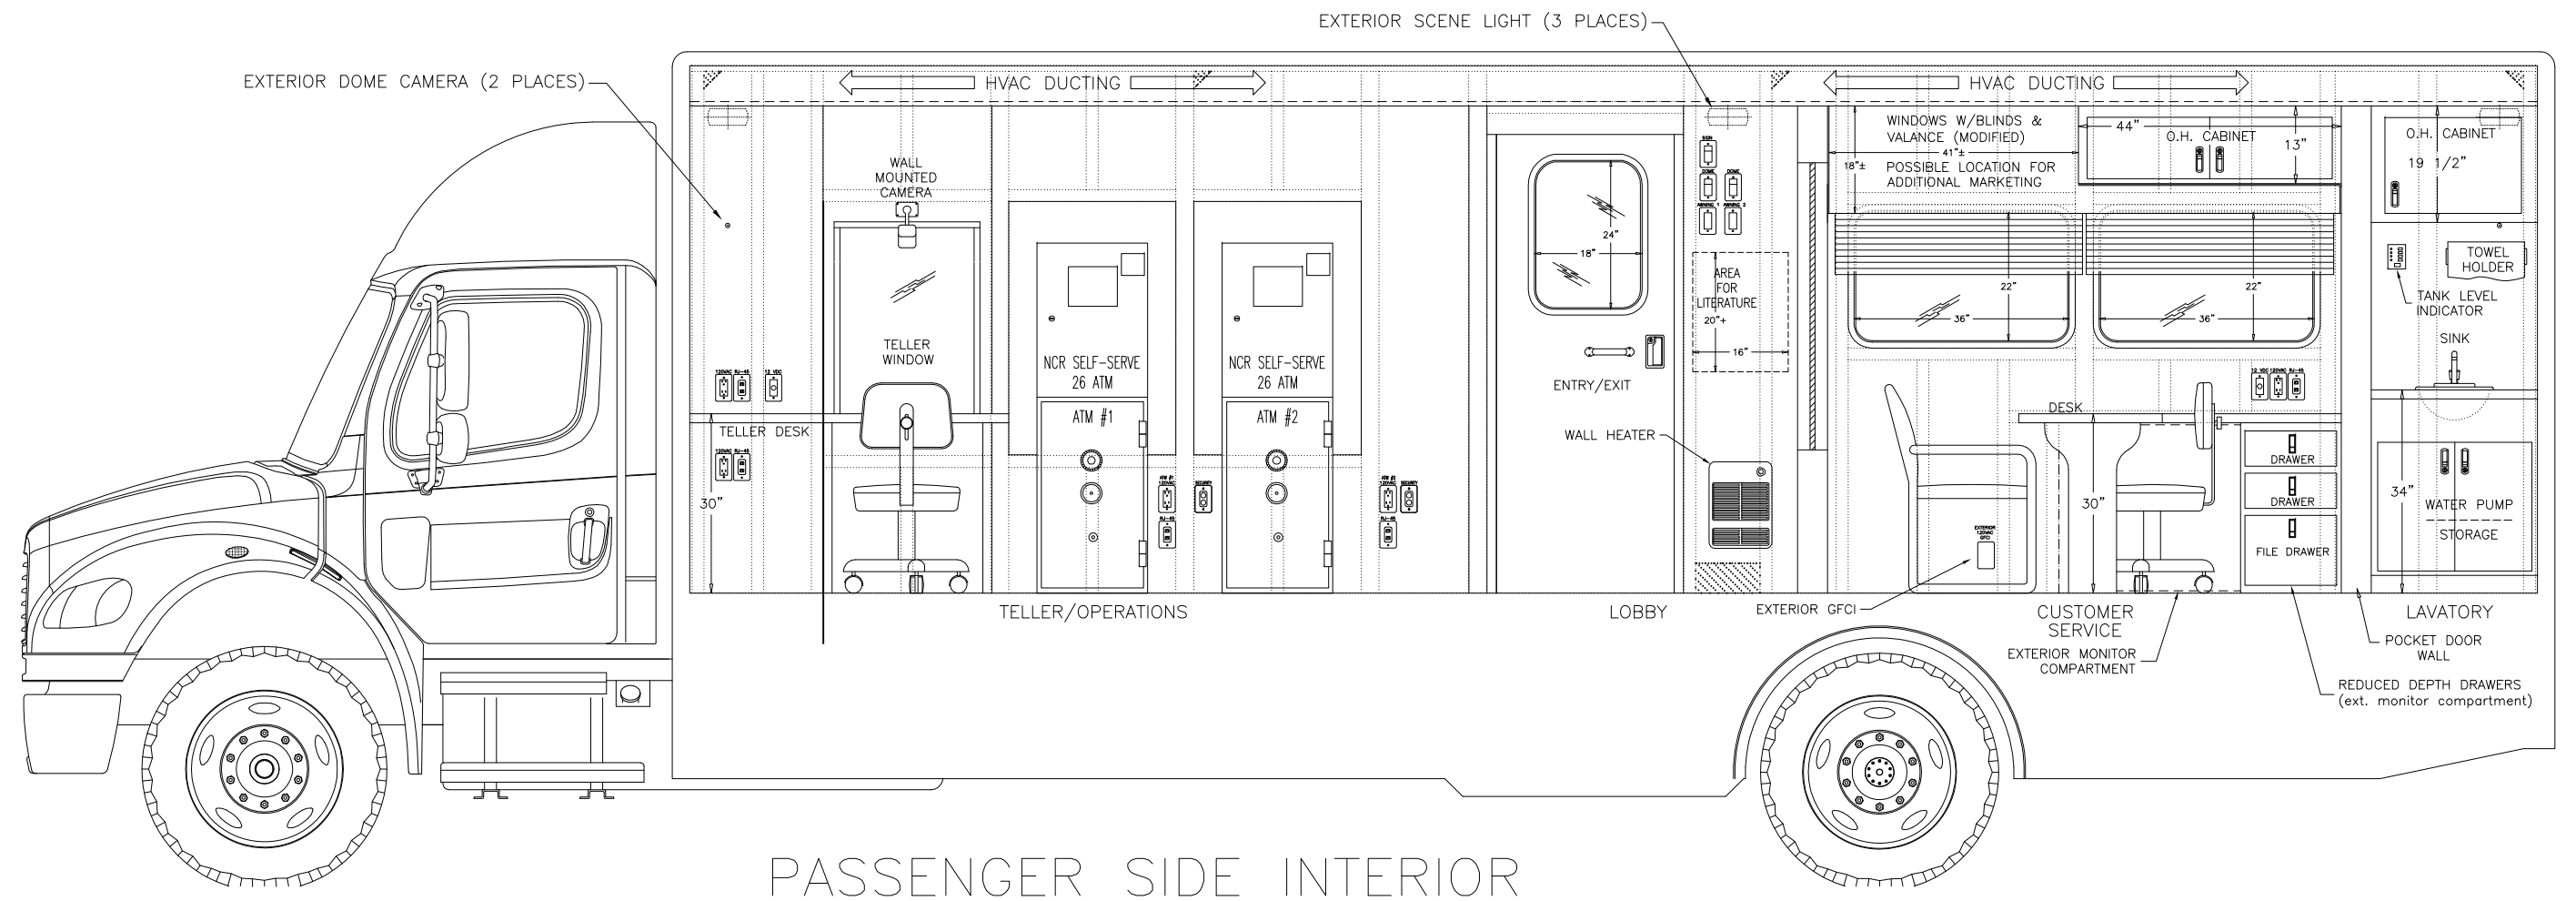

CUSTOMER APPROVAL

NAME: (print) \_\_\_\_\_  
 SIGNATURE: \_\_\_\_\_  
 TITLE: \_\_\_\_\_  
 DATE: \_\_\_\_\_

STATUS

PRELIMINARY SALES DRAWING  
 ALL DIMENSIONS  
 ARE APPROXIMATIONS

MBF Industries

210 TECH DRIVE  
 SANFORD, FLORIDA 32771

PHONE: 407-323-9414  
 FAX: 407-330-2068

DRAWING NUMBER  
 SUNTRUST\_ELEVATIONS\_6-6-12

CHASSIS/BODY  
 M2-106/MODULAR

TYPE  
 AS-BUILT

DATE  
 6/6/12

TITLE  
 SUNTRUST BANKS

VIEW  
 INTERIOR PASSENGER SIDE ELEVATION

DRAWN BY  
 GAJ



SHEET  
 2 of 8

SCALE  
 N/A



SIZE  
 B

These drawings and/or specifications are the proprietary property and trade secrets of MBF Ind. and are issued in strict confidence. No reproduction or use shall be made without prior written consent of MBF Ind.

TOP VIEW

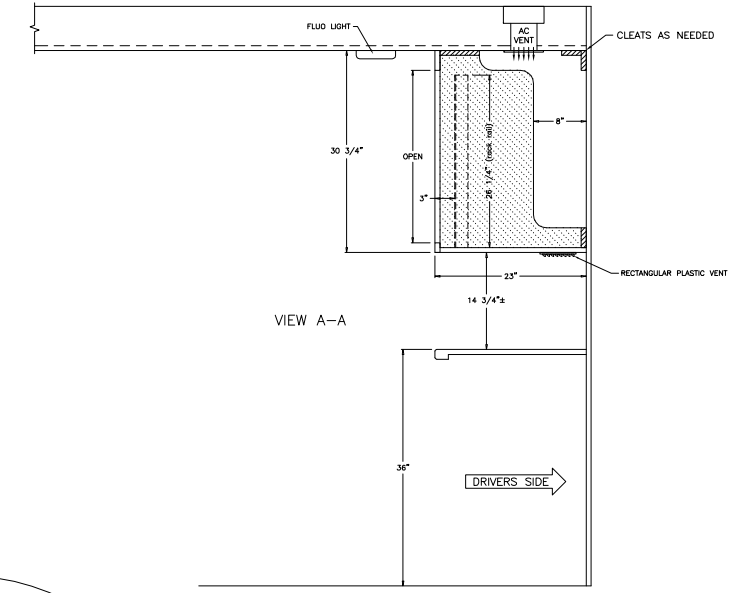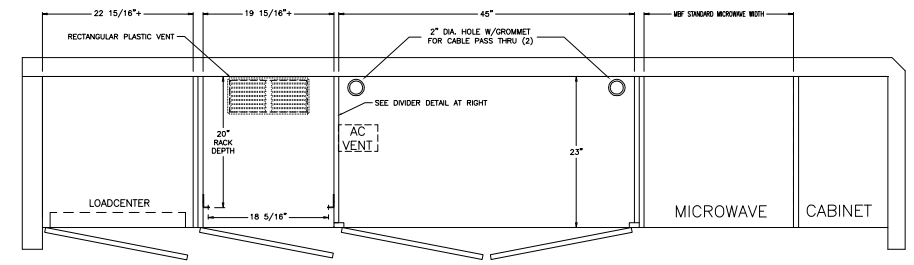

EXTERIOR SCENE LIGHT (3 PLACES)

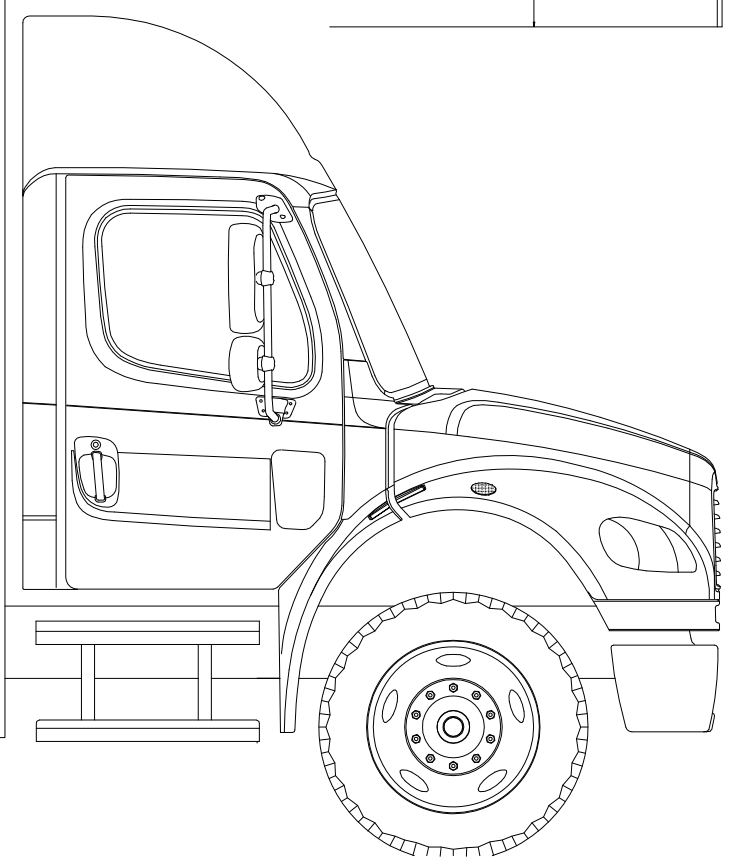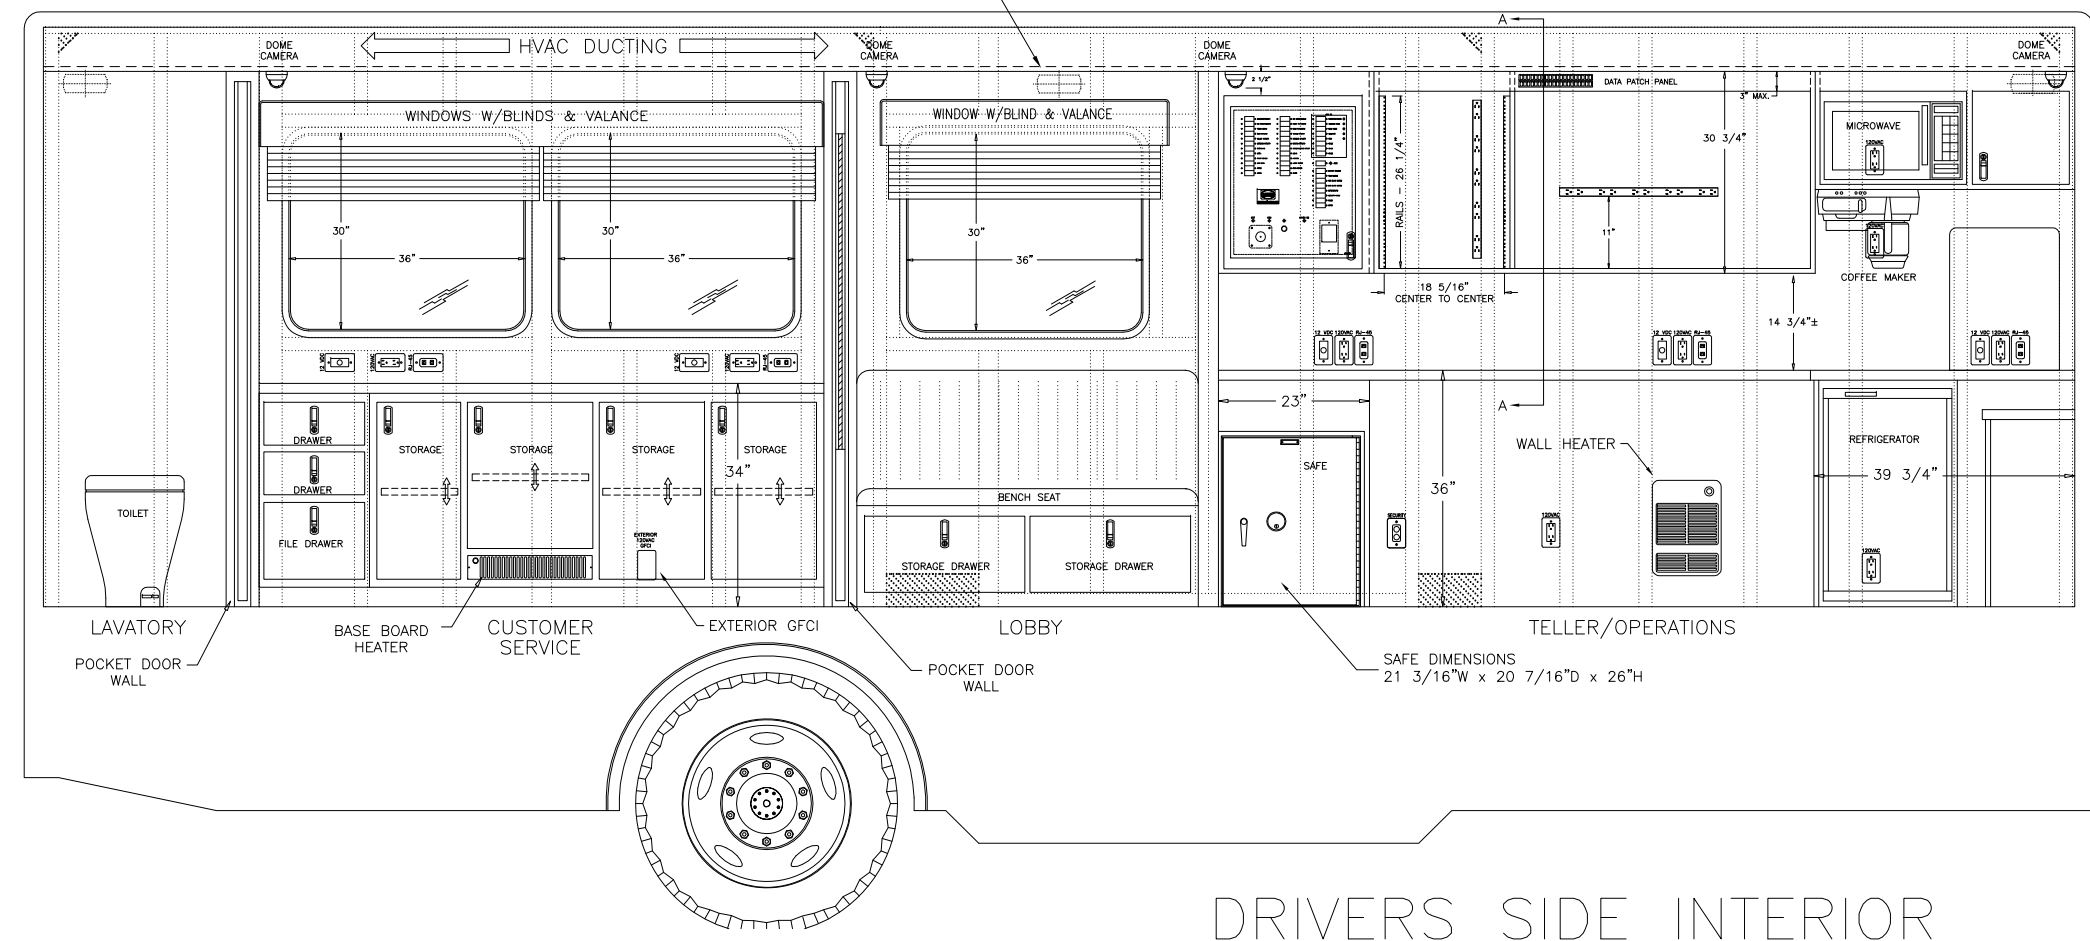

DRIVERS SIDE INTERIOR

CUSTOMER APPROVAL

NAME: (print) \_\_\_\_\_  
 SIGNATURE: \_\_\_\_\_  
 TITLE: \_\_\_\_\_  
 DATE: \_\_\_\_\_

STATUS

PRELIMINARY SALES DRAWING  
 ALL DIMENSIONS  
 ARE APPROXIMATIONS

MBF Industries

210 TECH DRIVE SANFORD, FLORIDA 32771 PHONE: 407-323-9414 FAX: 407-330-2068

DRAWING NUMBER  
 SUNTRUST\_ELEVATIONS\_6-6-12

TYPE  
 AS-BUILT

CHASSIS/BODY  
 M2-106/MODULAR

DATE  
 6/6/12


TITLE  
 SUNTRUST BANKS

VIEW  
 INTERIOR DRIVERS SIDE ELEVATION

DRAWN BY  
 GAJ  
 SHEET  
 3 of 8

SCALE  
 N/A  
 SIZE  
 B


These drawings and/or specifications are the proprietary property and trade secrets of MBF Ind. and are issued in strict confidence. No reproduction or use shall be made without prior written consent of MBF Ind.

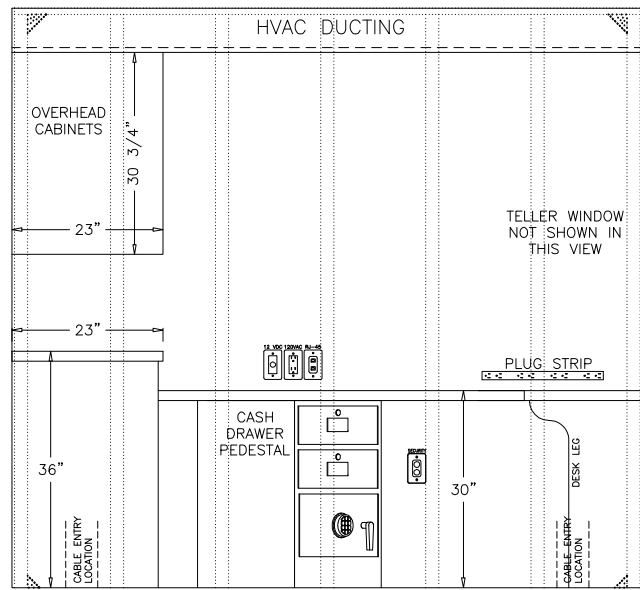

PASSENGER SIDE →

TELLER AREA  
FRONT WALL


VIEW A-A

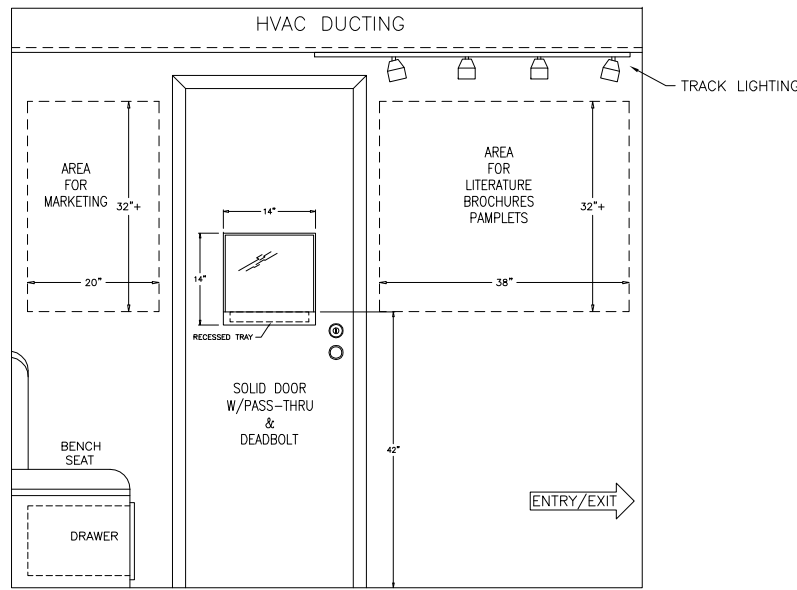

PASSENGER SIDE →

LOBBY AREA  
LOOKING TOWARD FRONT

VIEW B-B

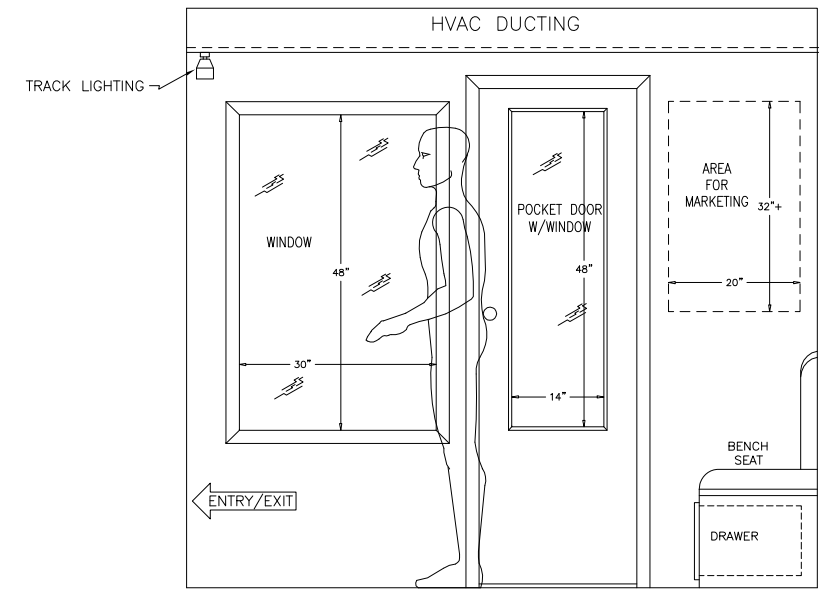

← PASSENGER SIDE

LOBBY AREA  
LOOKING TOWARD REAR

VIEW C-C

CUSTOMER APPROVAL

NAME: (print) \_\_\_\_\_  
SIGNATURE: \_\_\_\_\_  
TITLE: \_\_\_\_\_  
DATE: \_\_\_\_\_

STATUS

PRELIMINARY SALES DRAWING  
ALL DIMENSIONS  
ARE APPROXIMATIONS

MBF Industries

210 TECH DRIVE  
SANFORD, FLORIDA 32771

PHONE: 407-323-9414  
FAX: 407-330-2068

DRAWING NUMBER  
SUNTRUST\_ELEVATIONS\_6-6-12

CHASSIS/BODY  
M2-106/MODULAR

TITLE  
SUNTRUST BANKS

TYPE  
AS-BUILT


DATE  
6/6/12

VIEW  
INTERIOR SECTION VIEWS

These drawings and/or specifications are the proprietary property and trade secrets of MBF Ind. and are issued in strict confidence. No reproduction or use shall be made without prior written consent of MBF Ind.

DRAWN BY  
GAJ  
SHEET  
4 of 8

SCALE  
N/A  
SIZE  
B

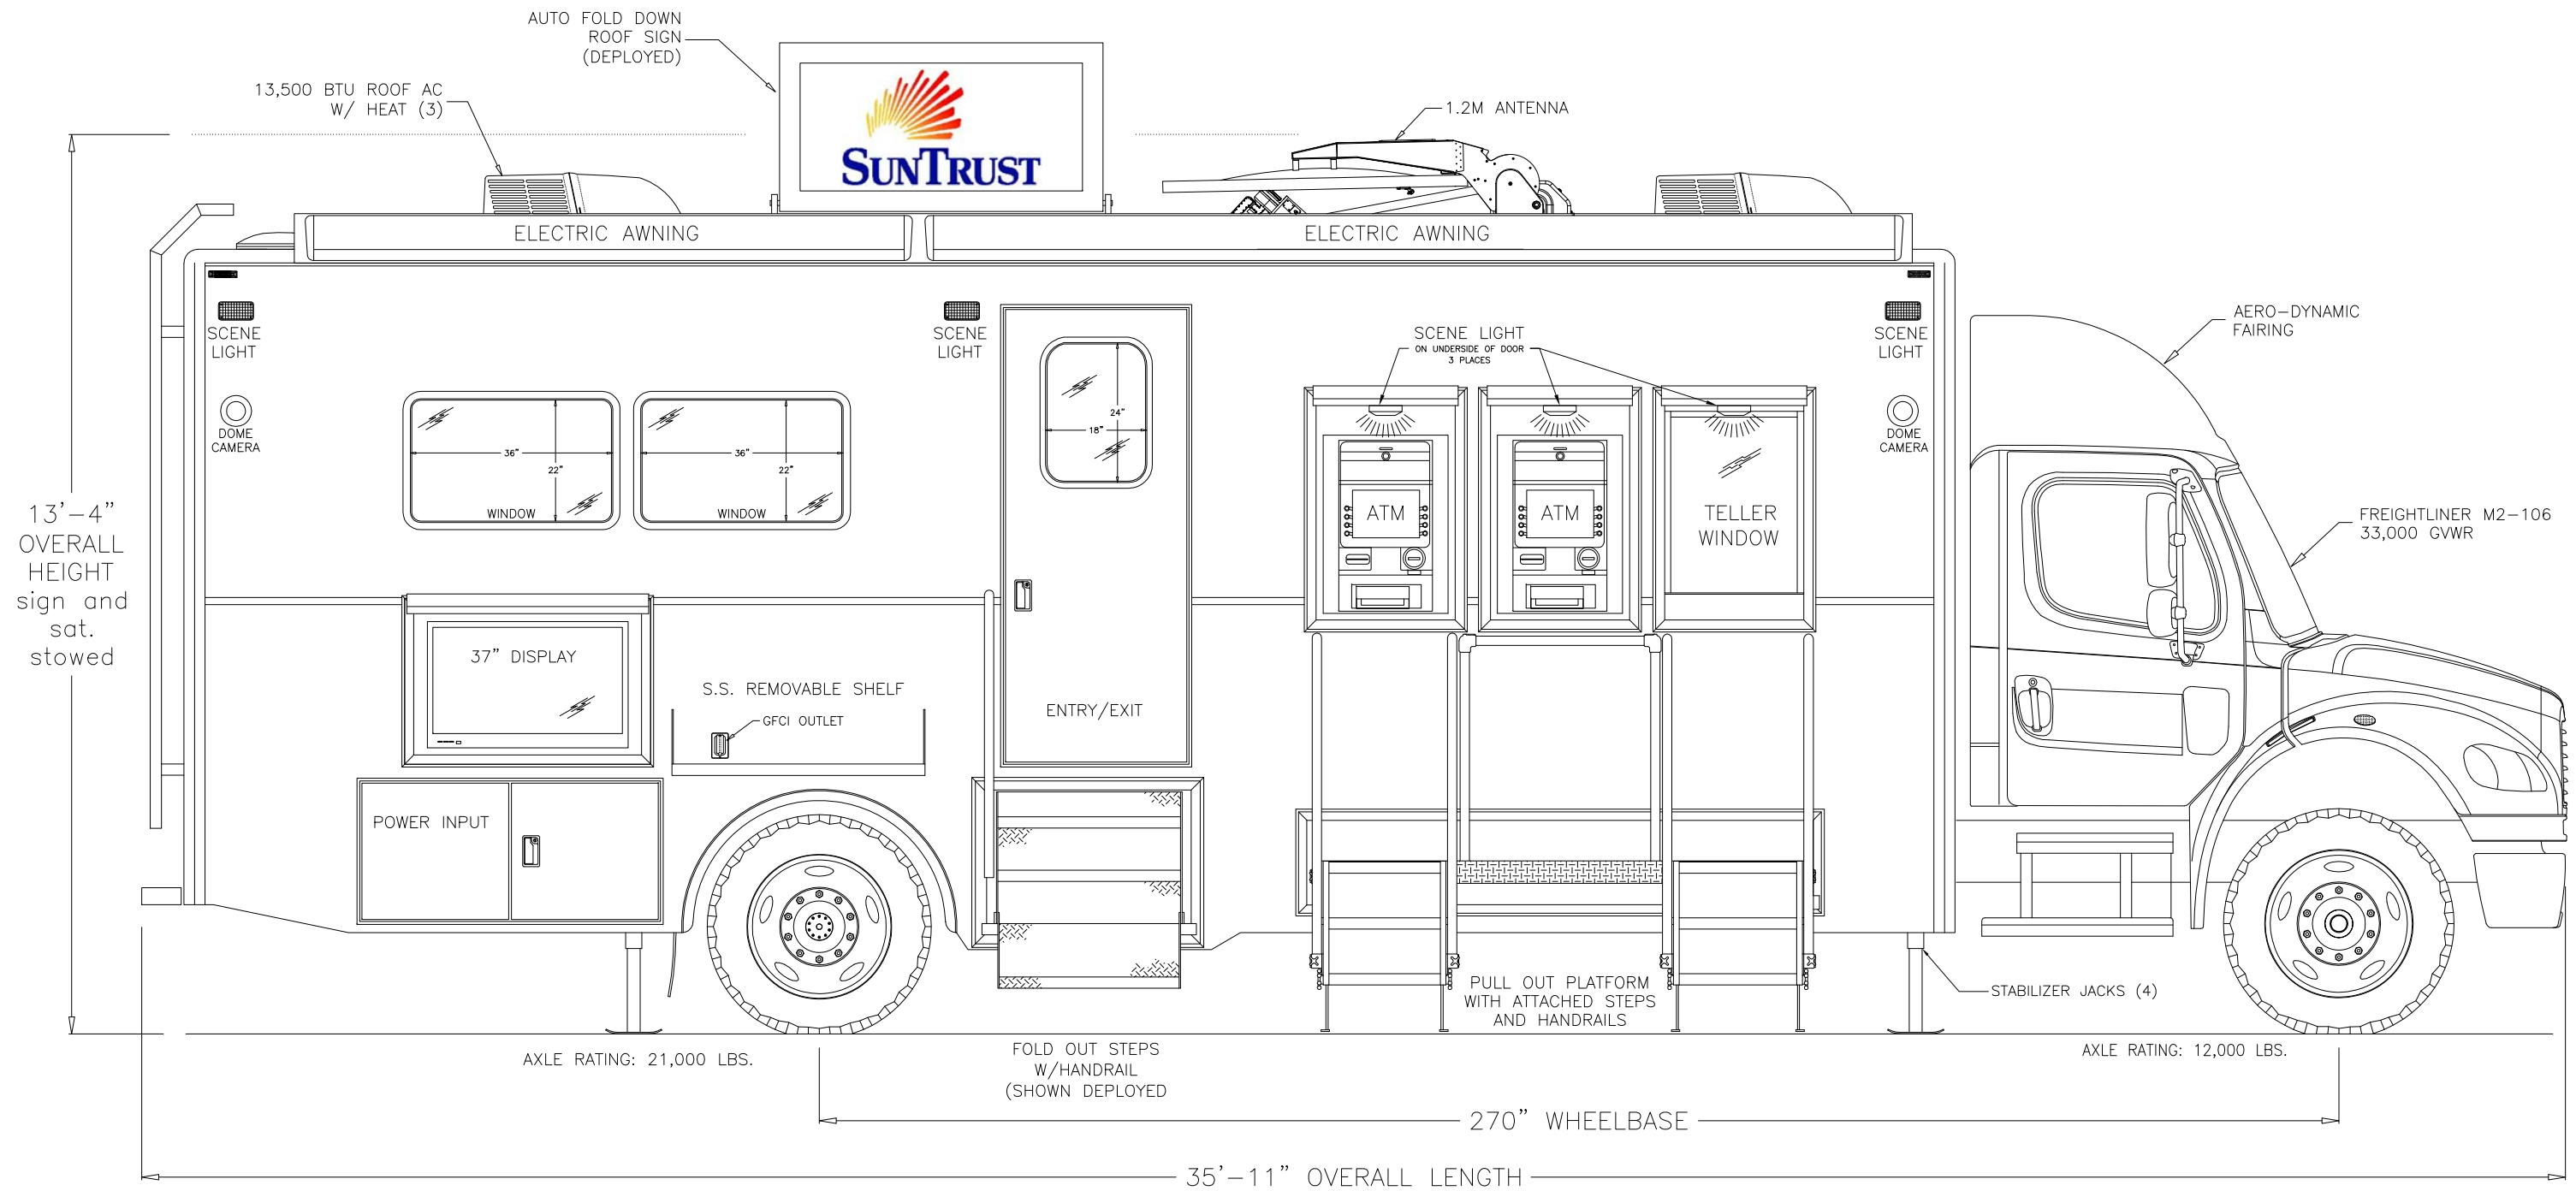

CUSTOMER APPROVAL

NAME: (print) \_\_\_\_\_  
 SIGNATURE: \_\_\_\_\_  
 TITLE: \_\_\_\_\_  
 DATE: \_\_\_\_\_

STATUS

PRELIMINARY SALES DRAWING  
 ALL DIMENSIONS  
 ARE APPROXIMATIONS

MBF Industries

210 TECH DRIVE  
 SANFORD, FLORIDA 32771

PHONE: 407-323-9414  
 FAX: 407-330-2068

DRAWING NUMBER  
 SUNTRUST\_ELEVATIONS\_6-6-12

CHASSIS/BODY  
 M2-106/MODULAR

TYPE  
 AS-BUILT

DATE  
 6/6/12


TITLE  
 SUNTRUST BANKS

VIEW  
 EXTERIOR PASSENGER SIDE ELEVATION

These drawings and/or specifications are the proprietary property and trade secrets of MBF Ind. and are issued in strict confidence. No reproduction or use shall be made without prior written consent of MBF Ind.

DRAWN BY  
 GAJ  
 SHEET  
 5 of 8

SCALE  
 N/A  
 SIZE  
 B

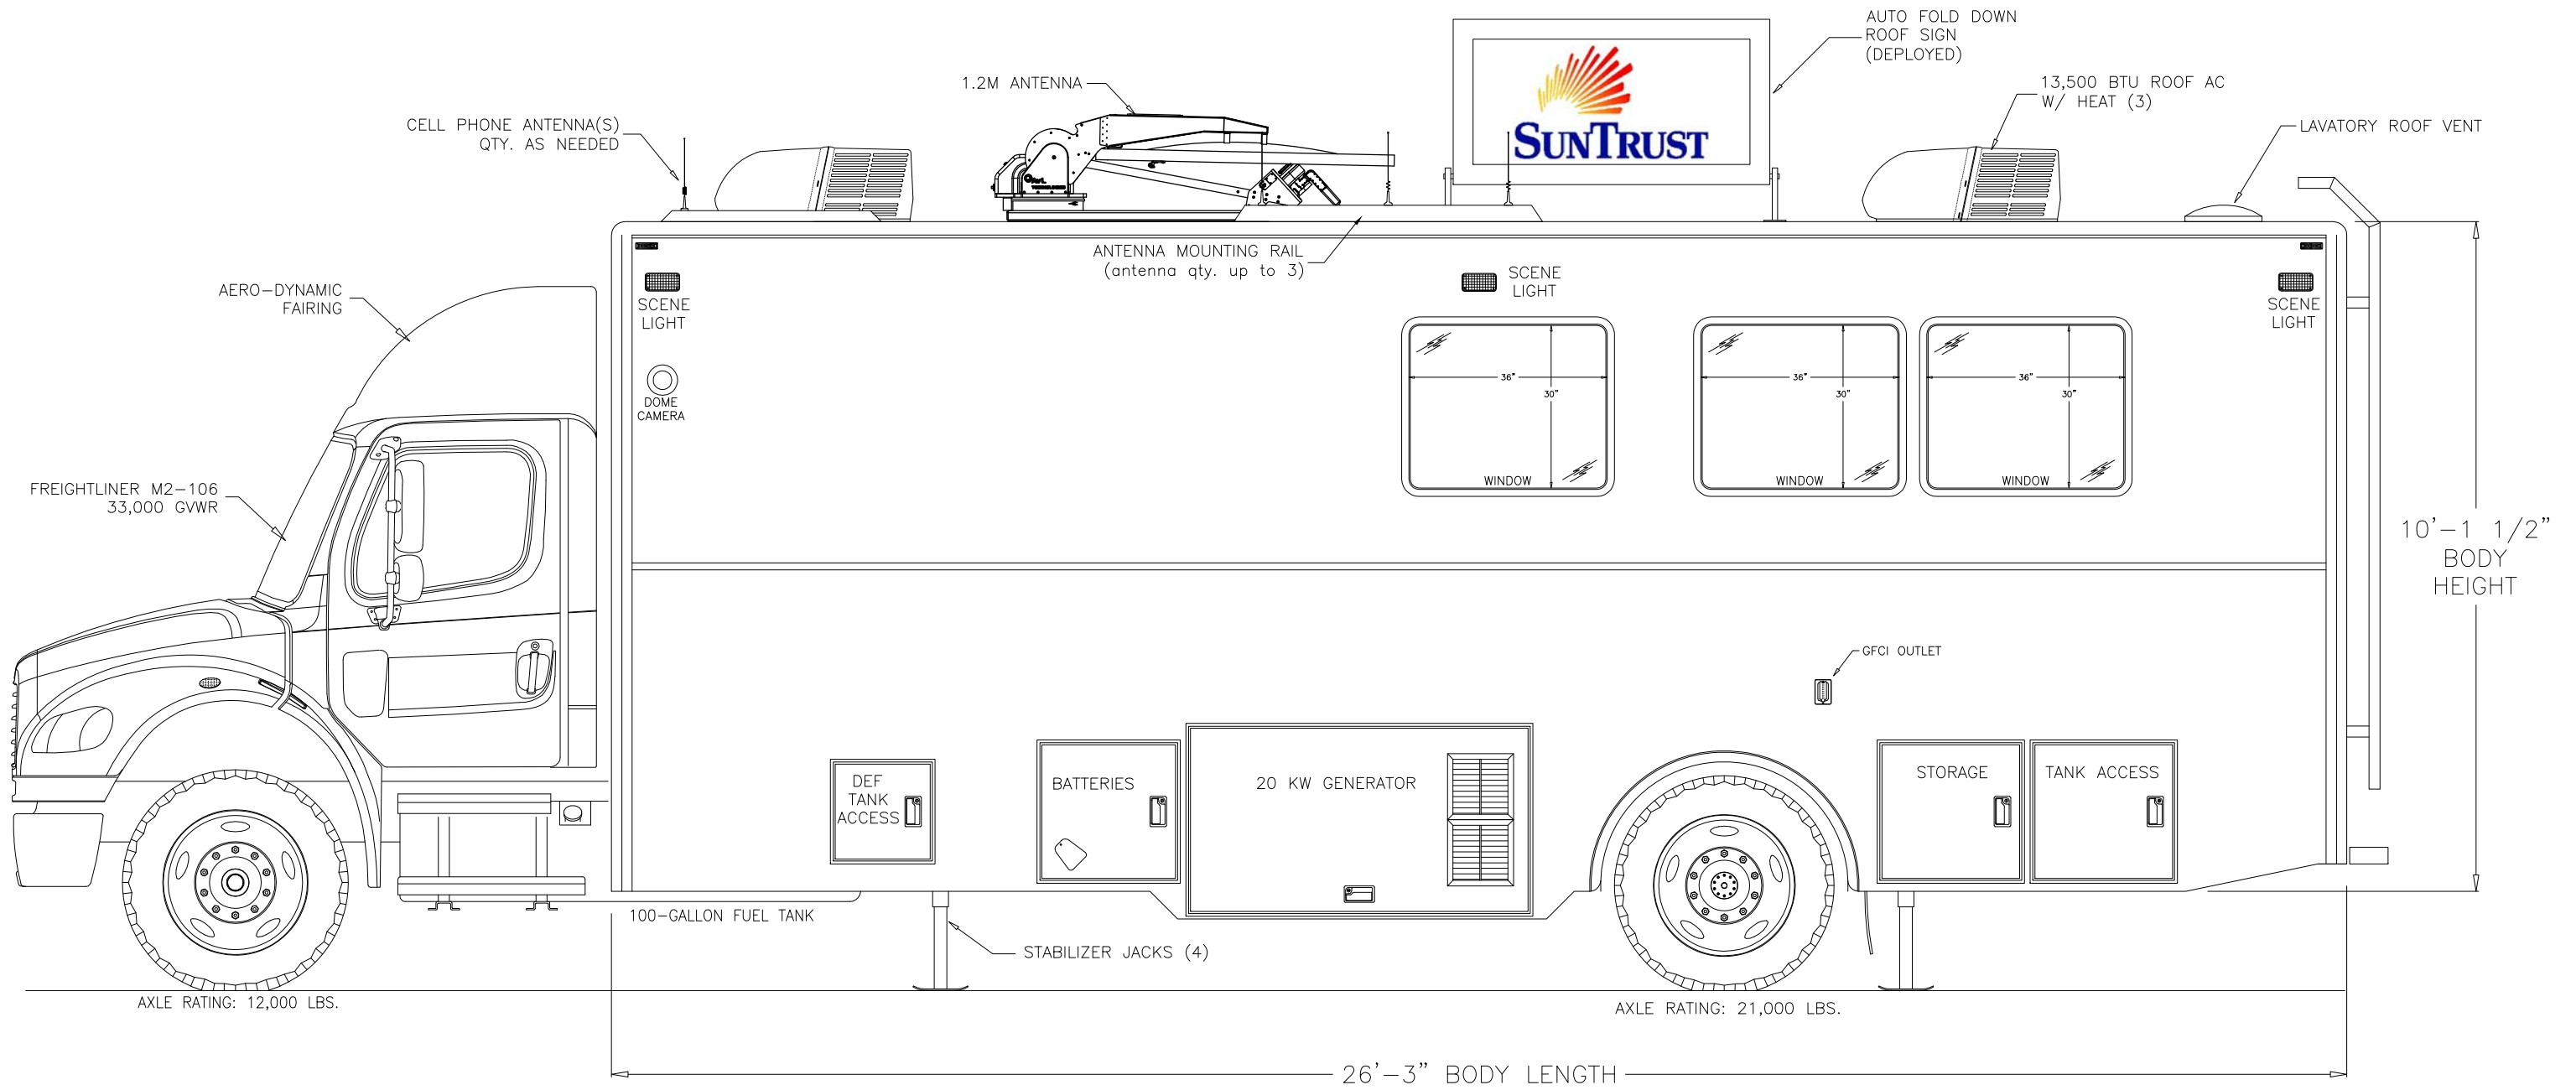

CUSTOMER APPROVAL

NAME: (print) \_\_\_\_\_  
 SIGNATURE: \_\_\_\_\_  
 TITLE: \_\_\_\_\_  
 DATE: \_\_\_\_\_

STATUS  
 PRELIMINARY SALES DRAWING  
 ALL DIMENSIONS  
 ARE APPROXIMATIONS

MBF Industries

210 TECH DRIVE  
 SANFORD, FLORIDA 32771

PHONE: 407-323-9414  
 FAX: 407-330-2068

DRAWING NUMBER  
 SUNTRUST\_ELEVATIONS\_6-6-12

CHASSIS/BODY  
 M2-106/MODULAR

TITLE  
 SUNTRUST BANKS

TYPE  
 AS-BUILT

DATE  
 6/6/12



VIEW  
 EXTERIOR DRIVERS SIDE ELEVATION

These drawings and/or specifications are the proprietary property and trade secrets of MBF Ind. and are issued in strict confidence. No reproduction or use shall be made without prior written consent of MBF Ind.

DRAWN BY  
 GAJ  
 SHEET  
 6 of 8

SCALE  
 N/A  
 SIZE  
 B

SOME ROOF MOUNTED EQUIPMENT  
NOT SHOWN IN THESE VIEWS

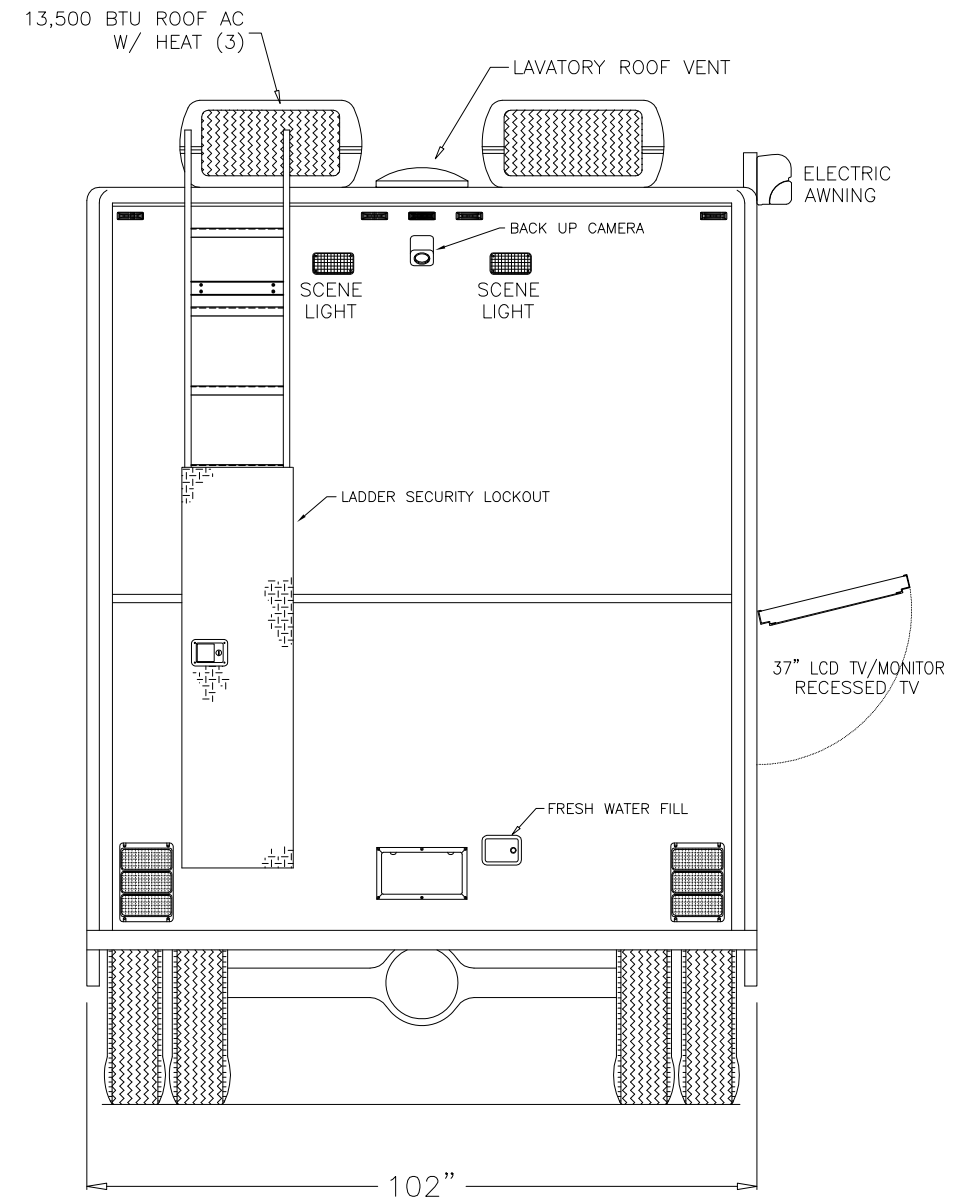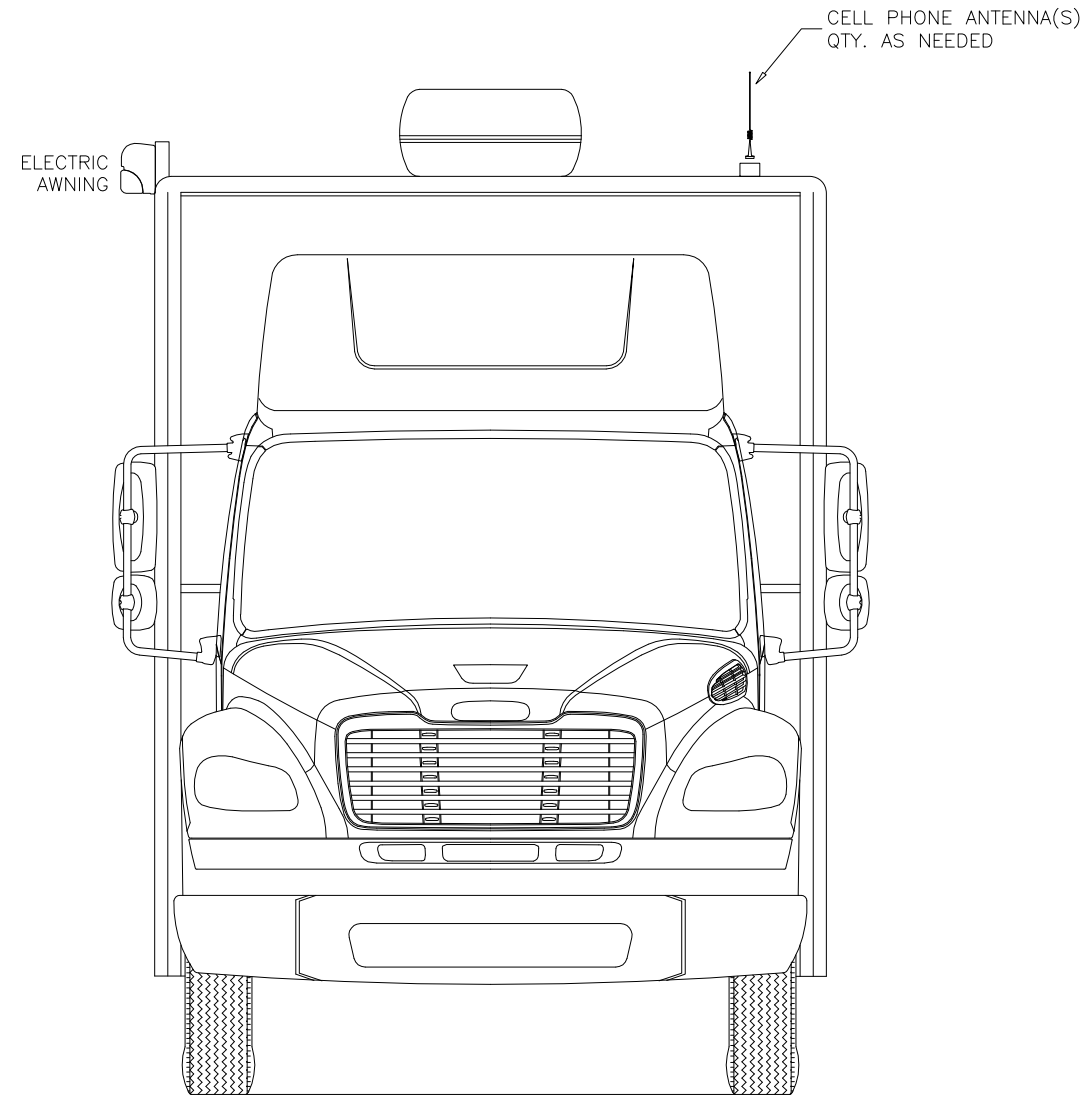

CUSTOMER APPROVAL

NAME: (print) \_\_\_\_\_  
SIGNATURE: \_\_\_\_\_  
TITLE: \_\_\_\_\_  
DATE: \_\_\_\_\_

STATUS

PRELIMINARY SALES DRAWING  
ALL DIMENSIONS  
ARE APPROXIMATIONS

MBF Industries

210 TECH DRIVE  
SANFORD, FLORIDA 32771

PHONE: 407-323-9414  
FAX: 407-330-2068

DRAWING NUMBER  
SUNTRUST\_ELEVATIONS\_6-6-12

CHASSIS/BODY  
M2-106/MODULAR

TITLE  
SUNTRUST BANKS

TYPE  
AS-BUILT

DATE  
6/6/12

VIEW  
EXTERIOR FRONT & REAR ELEVATION


These drawings and/or specifications are the proprietary property and trade secrets of MBF Ind. and are issued in strict confidence. No reproduction or use shall be made without prior written consent of MBF Ind.

DRAWN BY  
GAJ

SHEET  
7 of 8

SCALE  
N/A

SIZE  
B

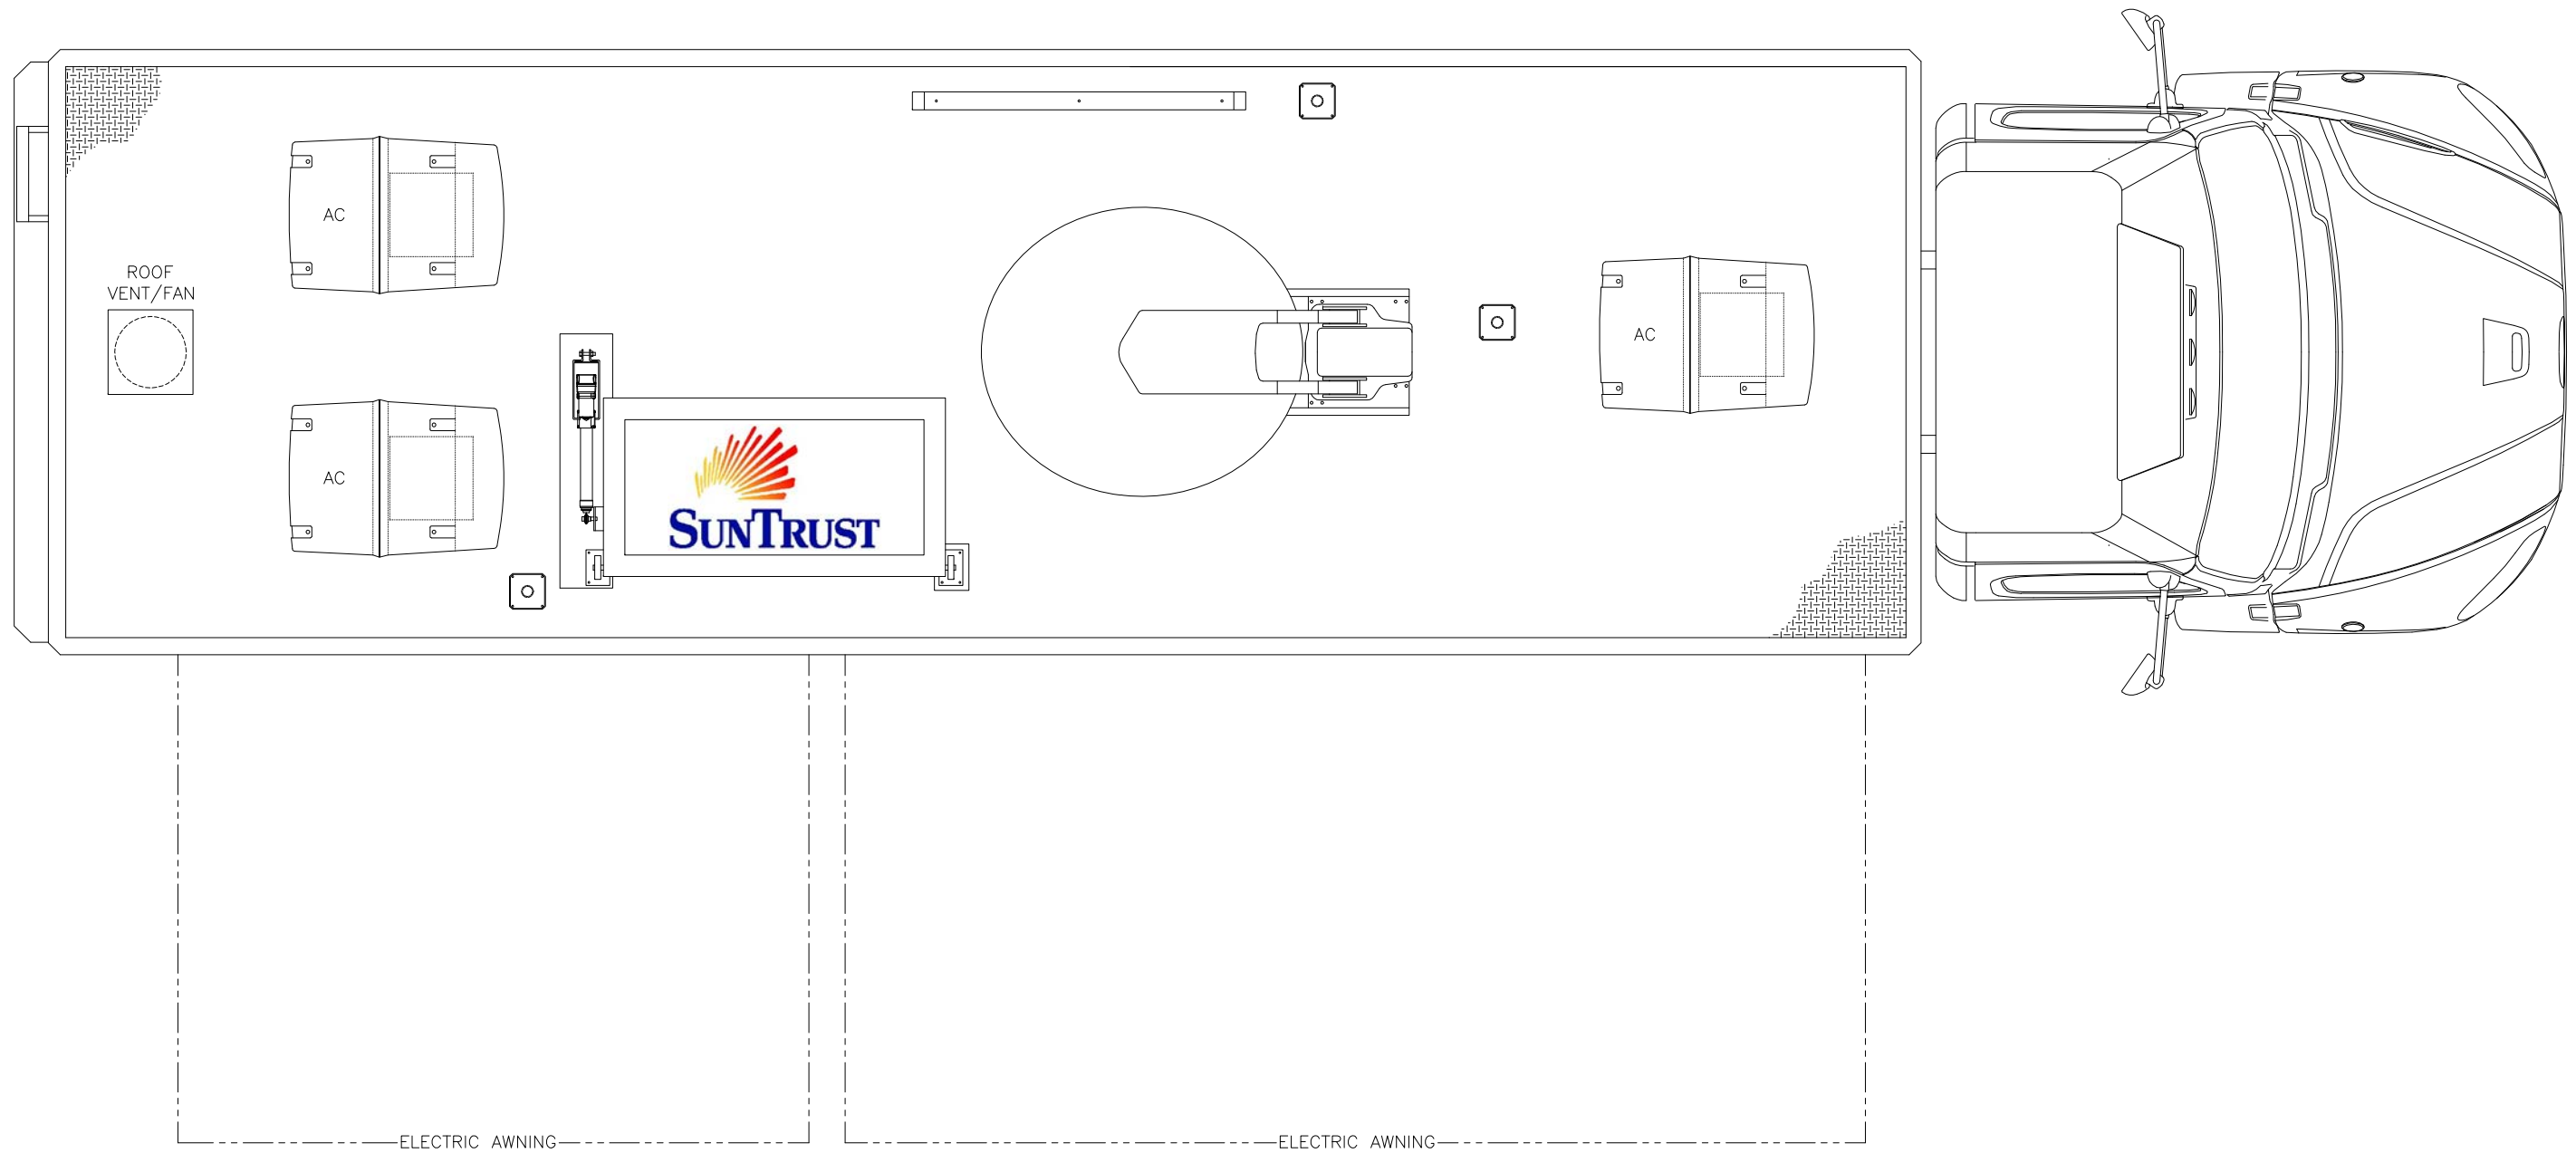

CUSTOMER APPROVAL

NAME: (print) \_\_\_\_\_  
 SIGNATURE: \_\_\_\_\_  
 TITLE: \_\_\_\_\_  
 DATE: \_\_\_\_\_

STATUS

PRELIMINARY SALES DRAWING  
 ALL DIMENSIONS  
 ARE APPROXIMATIONS

MBF Industries

210 TECH DRIVE  
 SANFORD, FLORIDA 32771

PHONE: 407-323-9414  
 FAX: 407-330-2068

DRAWING NUMBER  
 SUNTRUST\_ELEVATIONS\_6-6-12

CHASSIS/BODY  
 M2-106/MODULAR

TITLE  
 SUNTRUST BANKS

TYPE  
 AS-BUILT

DATE  
 6/6/12

VIEW  
 ROOF LAYOUT

These drawings and/or specifications are the proprietary property and trade secrets of MBF Ind. and are issued in strict confidence. No reproduction or use shall be made without prior written consent of MBF Ind.

DRAWN BY  
 GAJ  
 SHEET  
 8 of 8

SCALE  
 N/A  
 SIZE  
 B